



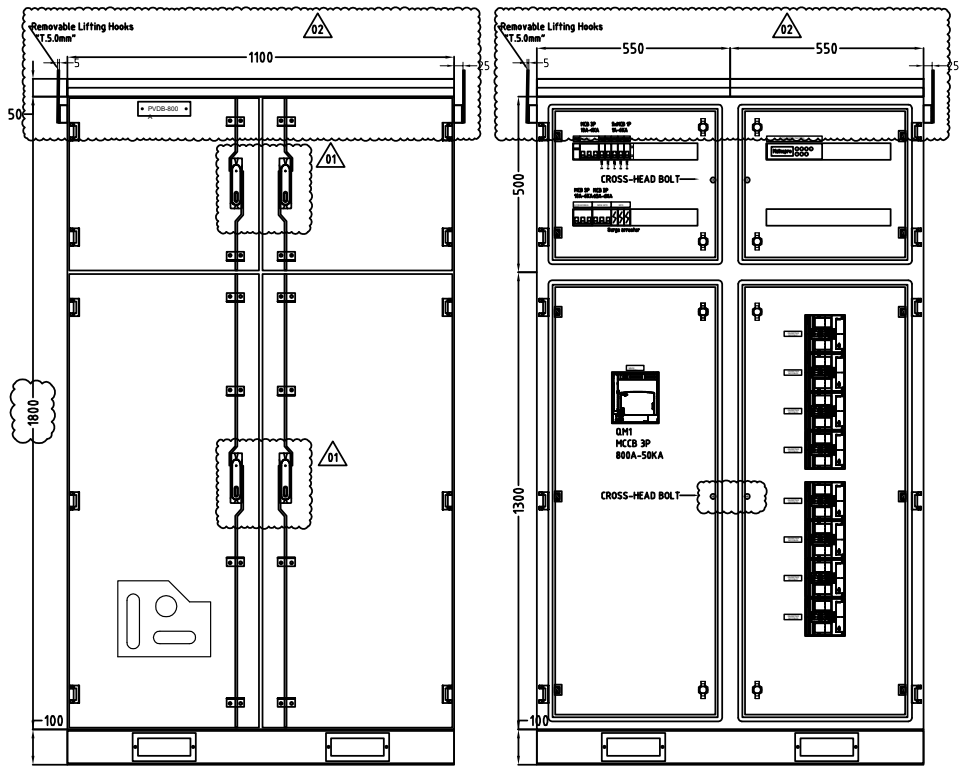


FRONT VIEW


INSIDE VIEW
(With Escutcheon)

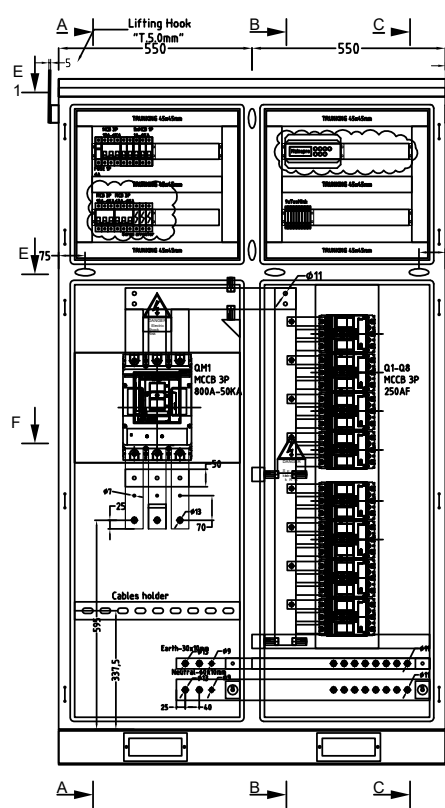


INSIDE VIEW
(Without Escutcheon)

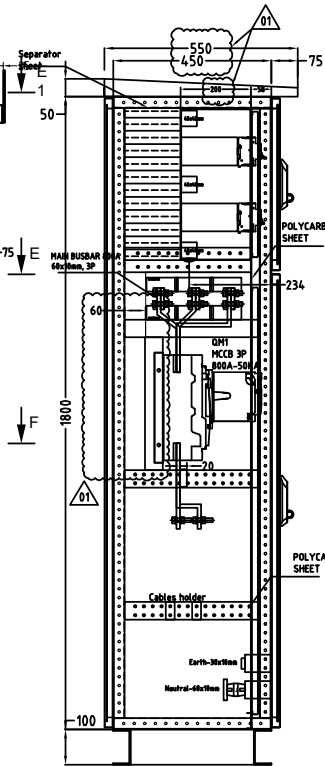


SECTION VIEW A-A

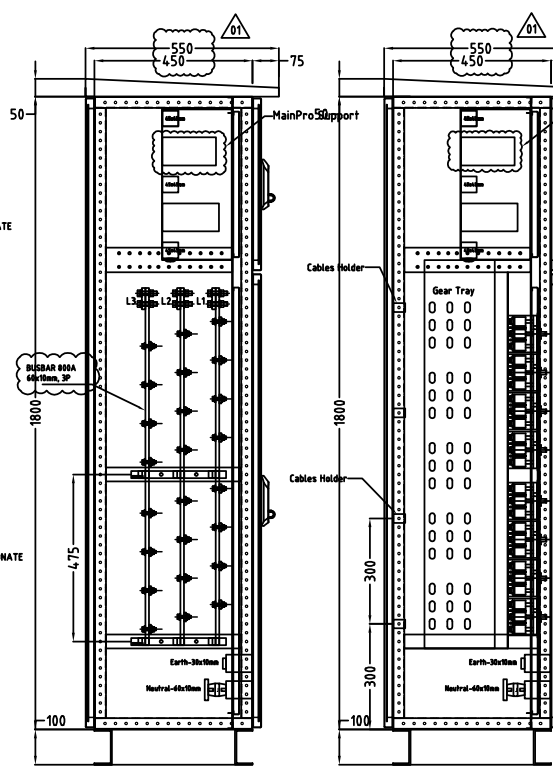


SECTION VIEW B-B

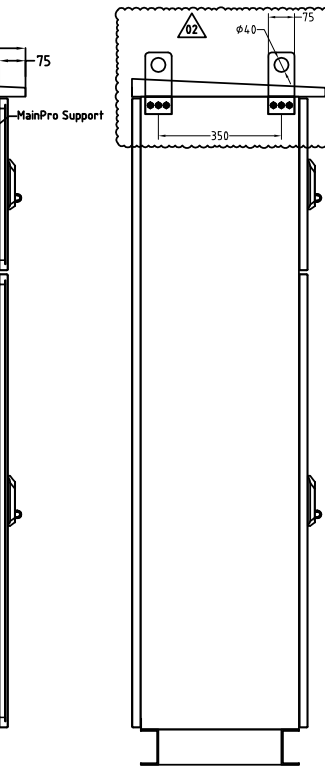


SECTION VIEW C-C

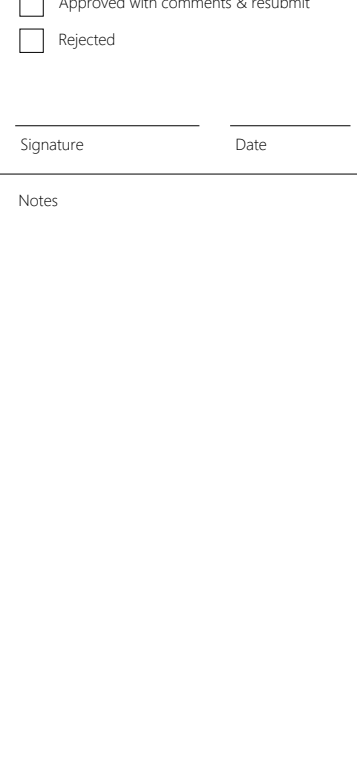


SIDE VIEW

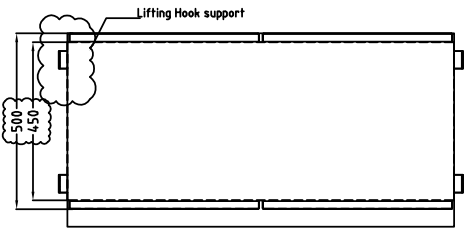


TOP VIEW

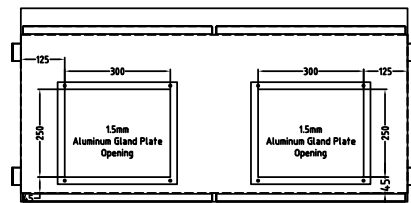


BOTTOM VIEW

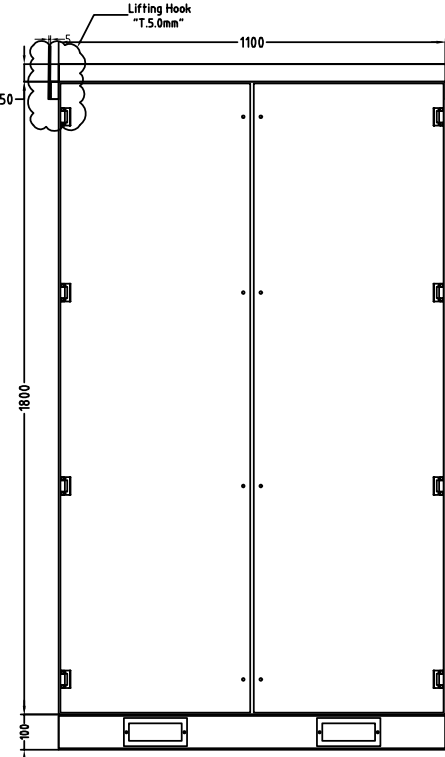


REAR VIEW

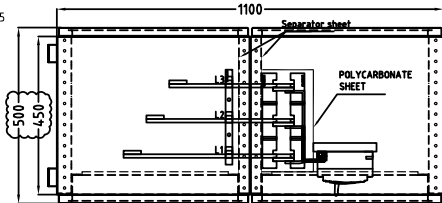

SECTION VIEW E-E

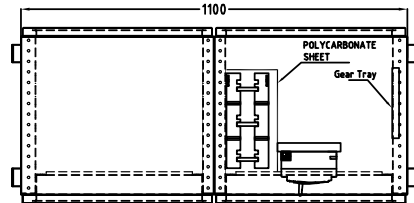

SECTION VIEW F-F

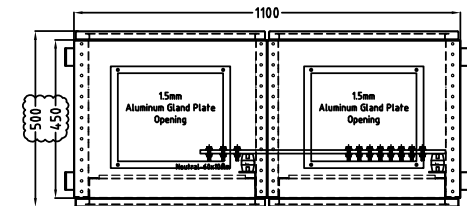

SECTION VIEW E1-E1 TOP GLAND PLATE
(RAIN-HOOD REMOVED)

02 Updated: Mar. 28/2025

TECHNICAL DATA		
DIMENSION (W x H x D)[mm]:		1100 X 1800+100+50 X 500
QUANTITY :		
DEGREE OF PROTECTION (IP) :		65
FORM :		1
STRUCTURE & THICKNESS PANEL [mm]: STEEL		
FRAME : 2.0	FRONT DOOR : 2.0	INNER DOOR : 1.5
MOUNTING : 2.0	BASE : 4.0	
LOCATION:	☐ INDOOR	☒ OUTDOOR
TYPE :	☐ WALL MOUNTED	☒ SELF STANDING
COLOUR : RAL7035	☒ MATT	☐ GLOSS
CONNECTION :	☒ FRONT ACCESS	☐ REAR ACCESS
CABLES ENTRANCE :	INCOMING : ☐ TOP	☒ BOTTOM
	OUTGOING : ☐ TOP	☒ BOTTOM

THIS DRAWING HAS BEEN CHECKED FOR COMPLIANCE WITH DESIGNED INTENT WITH COMMENTS

- ☐ Approved
- ☐ Approved with comments
- ☐ Approved with comments & resubmit
- ☐ Rejected

Signature _____ Date _____

Notes

Drawing Status

☐ SUBMISSION

☒ FOR CONSTRUCTION

☐ AS-BUILT

	Name	Date	Sign
Designed			
Checked			
Approved			
Scale	1:15	Size	A3

Drawing Title:

PVDB 630/800A
General Arrangement

Drawing No.	Date	Rev

Client:

Project Title:

NOARK
NOARK AUSTRALIA PTY LTD
Warehouse 1 10-12 Fairfield Rd
Padstow 2211 NSW
support@noark.au